



Gross External Area  
1530,11 m<sup>2</sup>  
Gross Internal Area  
1422,45 m<sup>2</sup>

3rd Angle Projection U.N.O.

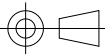

Do not scale this print.

Notes

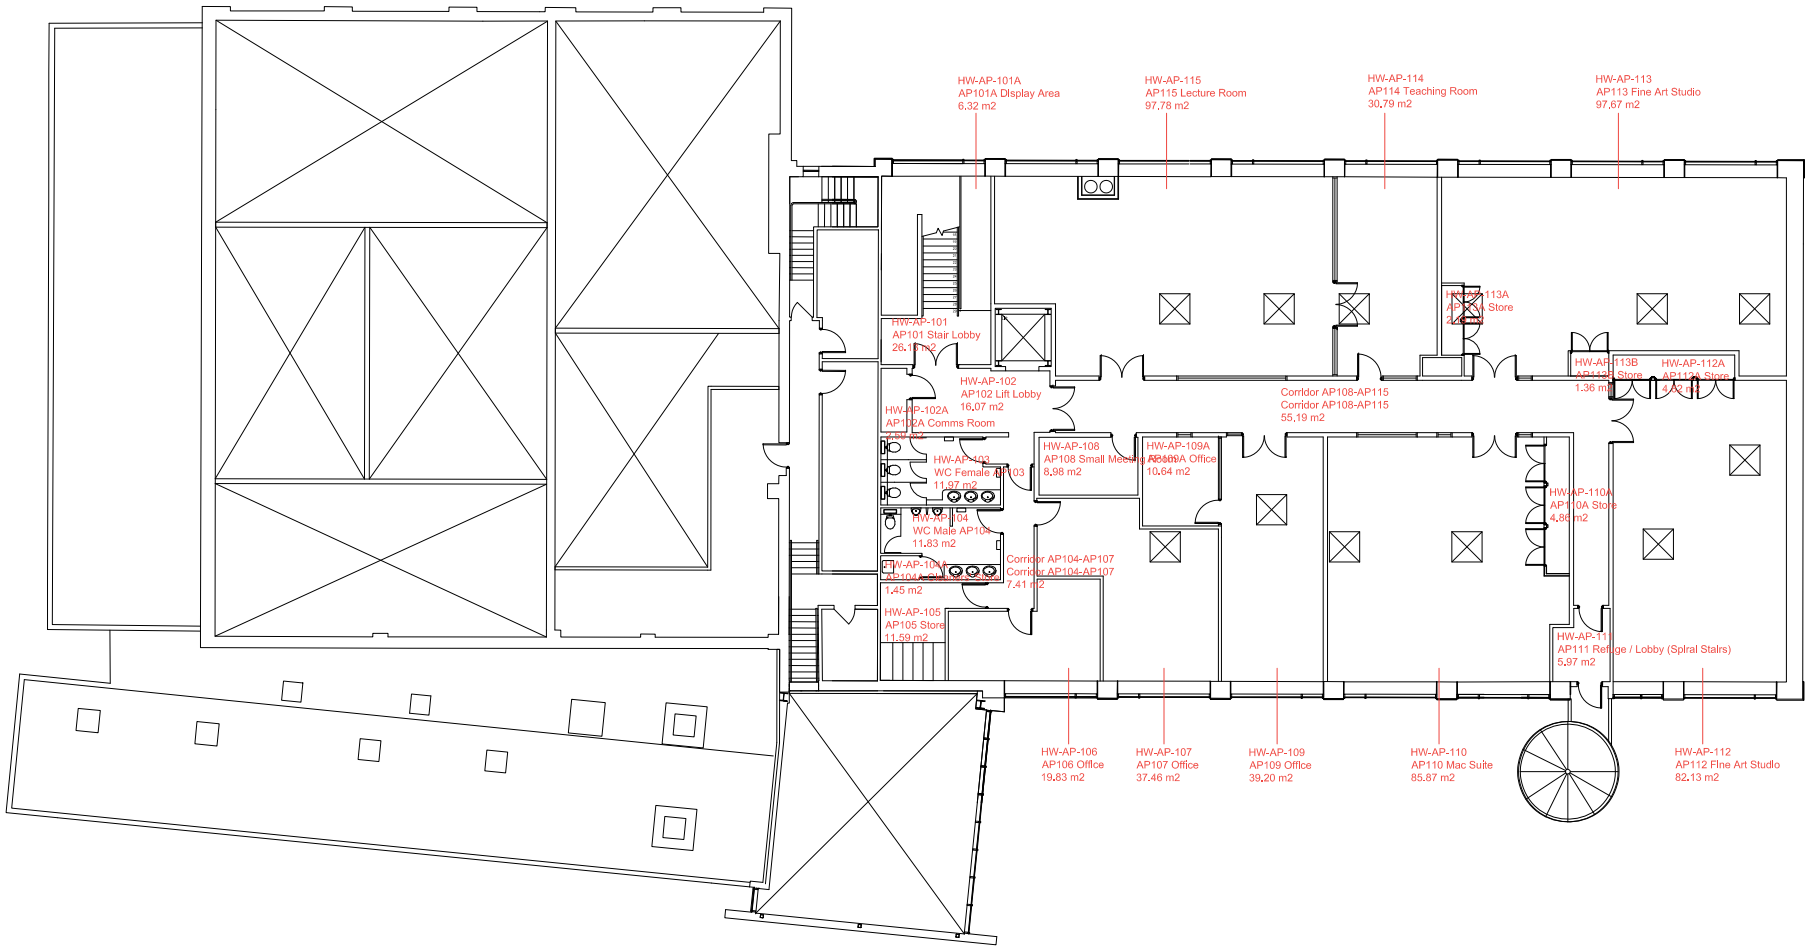

0m 5m 10m



Rev	Comment	By	Date
-----	---------	----	------



Dunholme Villa  
The Park Campus  
The Park  
Cheltenham  
GL50 2RH  
t: 01242 714888

Drawing Status  
As Built

Campus Location  
Hardwick  
Cheltenham

Drawing Title  
Centre for Art & Photography  
First Floor  
Floor Plan

Scale	Drawn	Check	Rev.
1:300 @ A3	SW		00

Date  
30-11-2021

Drawing Number  
HW-AP-1-FP