
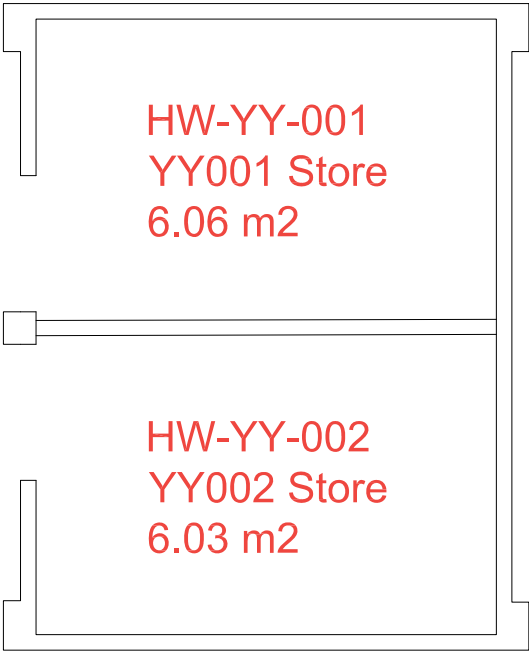


Gross External Area  
14.06 m2

Gross Internal Area  
12.39 m2

← Maidenhorn

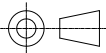

3rd Angle Projection U.N.O. 

Do not scale this print.

Notes

Rev	Comment	By	Date
-----	---------	----	------

**UNIVERSITY OF  
GLOUCESTERSHIRE**

Estates Department  
Dunholme Villa  
Park Campus  
Cheltenham  
GL50 2RH  
t: 01242 714 888

Drawing Status  
**As Built**

Campus Location  
**Hardwick Campus  
Cheltenham GL50 4BS**

Drawing Title  
**Store by Maidenhorn  
Ground Floor  
Floor Plan**

Scale	Drawn	Check	Rev.
<b>1:50 @ A3</b>	<b>SW</b>		<b>00</b>

Date  
**13-07-2022**

Drawing Number  
**HW-YY-0-FP**