


**Notes**



Rev	Comment	By	Date

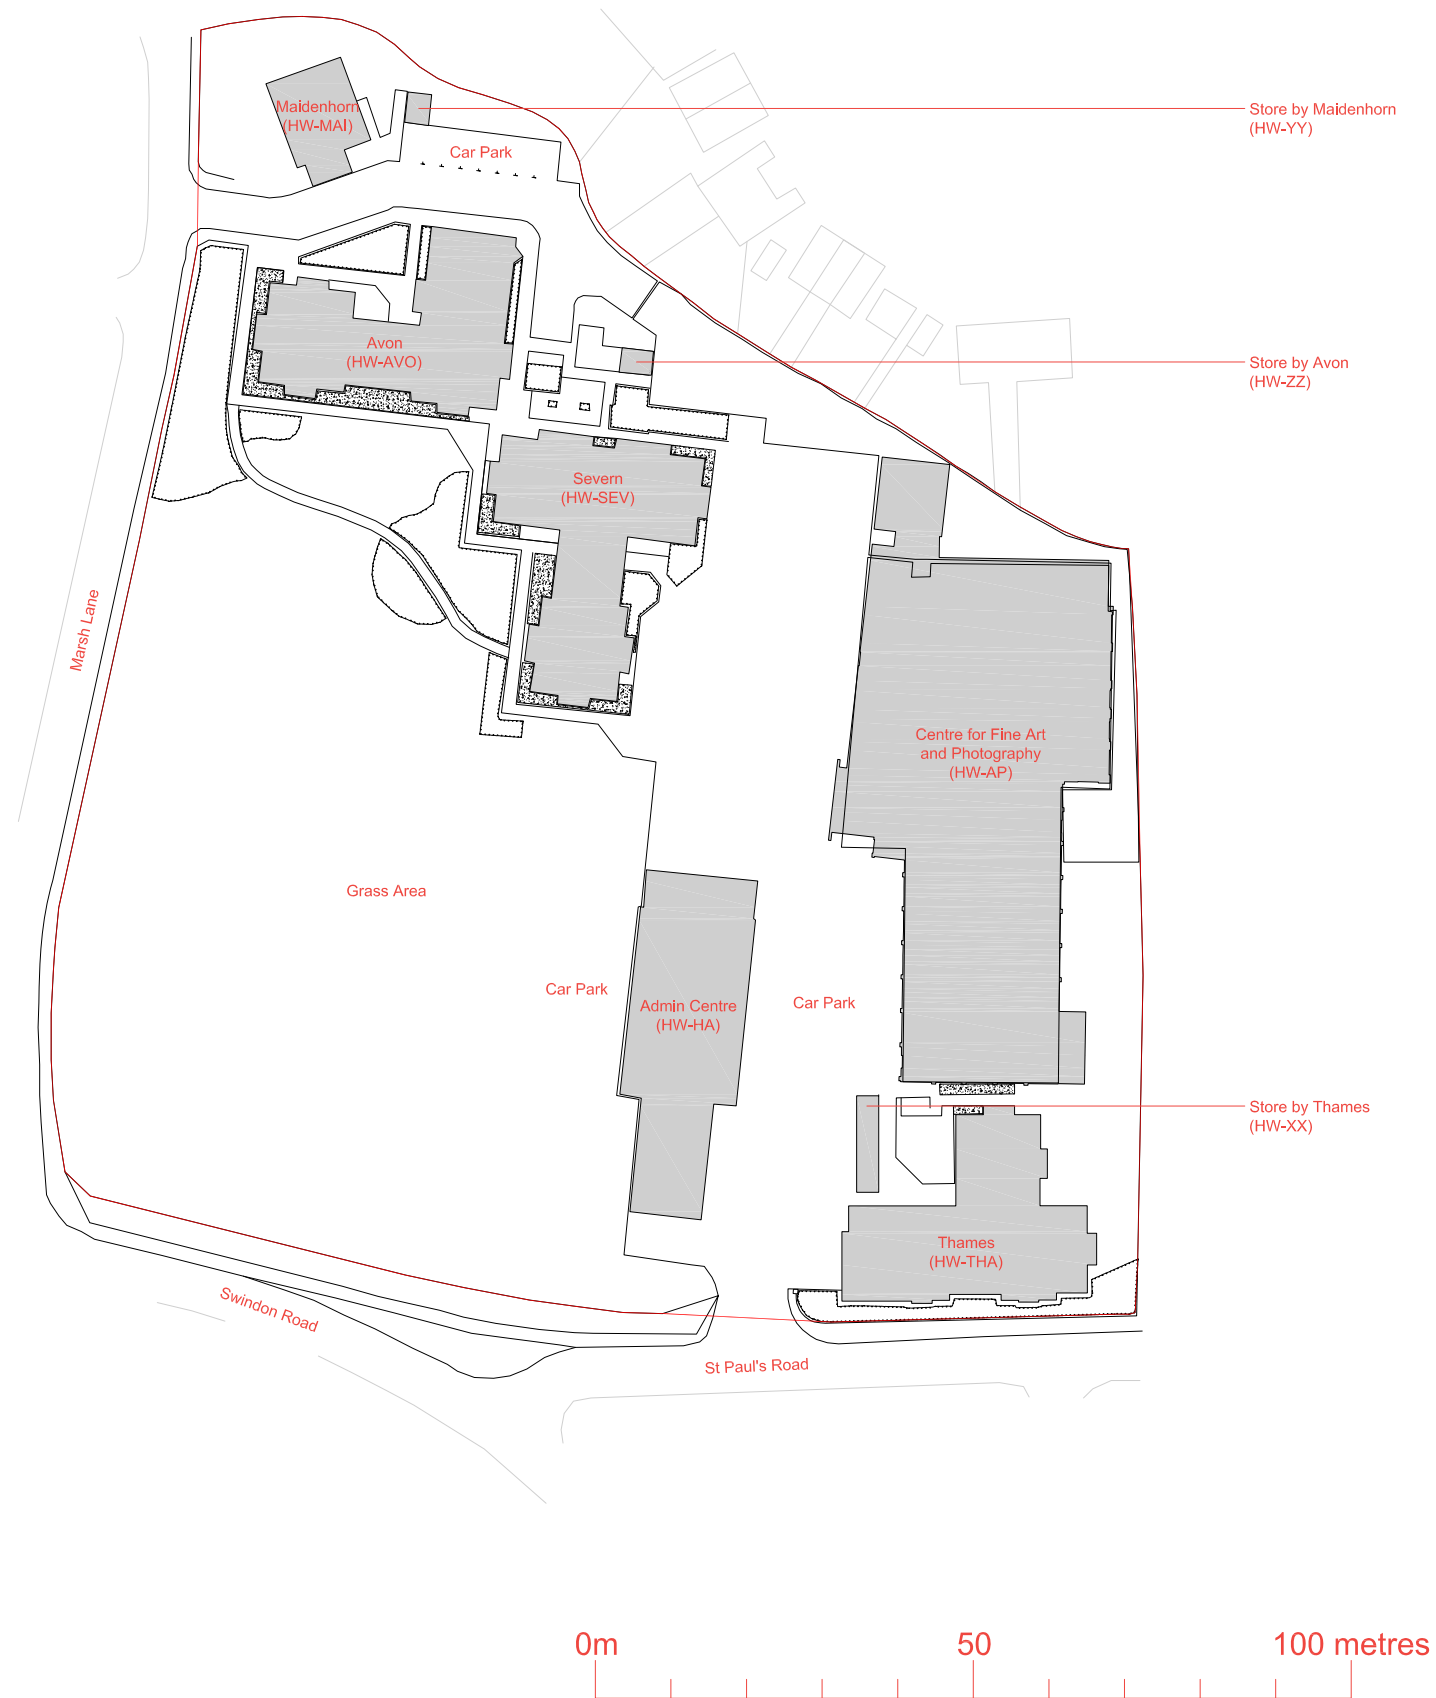

Estates Department  
 Dunholme Villa  
 Park Campus  
 Cheltenham  
 GL50 2RH  
 t: 01242 714 888

Drawing Status

**As Built**

Campus Location

**Hardwick  
 Cheltenham GL50 4BS**

Drawing Title

**Key Plan**

Scale	Drawn	Check	Rev.
1:1000 @ A3	SW		00

Date  
**10-05-2022**

Drawing Number

**HW-Key**